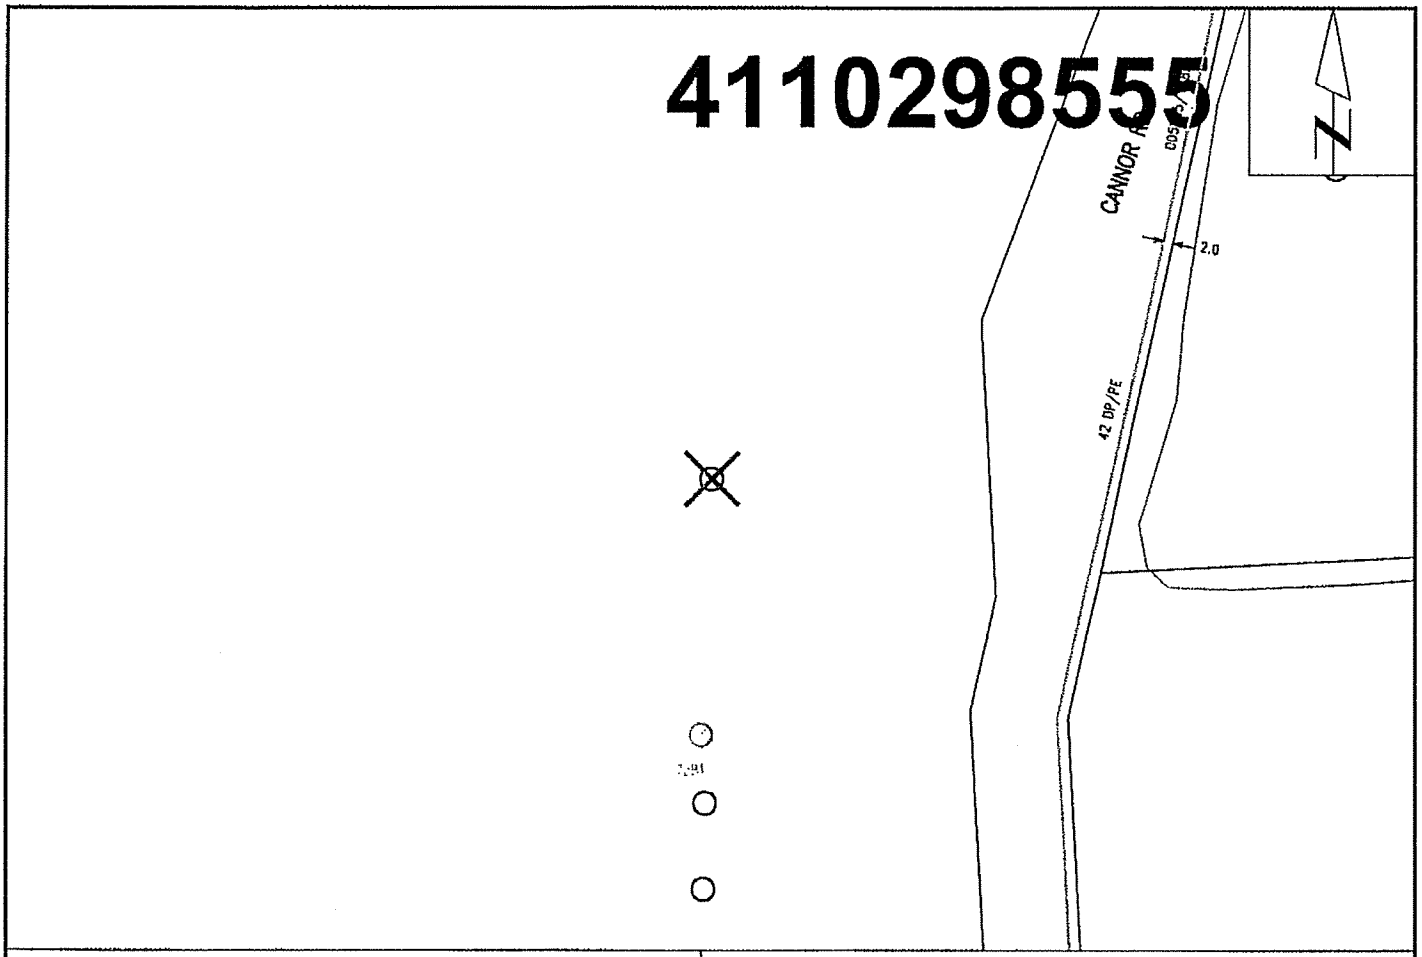

View Scale: 1:1000

7281 Cannor Rd T, Chilliwack

Order #: 30999559 Prem #: 279335 City Limits: Chilliwack

X: 1287276142.00 Y: 465568895.00

2018/05/04

T 7281 CANNOR ROAD CHILLIWACK 5/4/2018 11:07:59 AM

ATTENTION: DO NOT RELY ON THIS INFORMATION ALONE. You must manually dig to locate gas lines before using excavation machinery. All locations are shown approximate only & gas lines built after the date below are not in this information package. FortisBC will not accept responsibility for errors or omissions. Depth of gas line are not available due to possible change of grade.

	UNIT #	HOUSE #	ST. DIR.	ST. NAME	SUFFIX	MNCP.	TRANS ☐ TRUNK ☐
ADDRESS SERVED	1	7285		CANNOR	RD	CHL	HIGH ☑ MED. ☐ LOW ☐

MAIN SERVED FROM SIZE 1 1/4" OFFSET 2.0 m FROM E. SIDE OF CANNOR RD. DEPTH 1.0 m MAT. ST. ☐ CI. ☐ PL. ☐ PE. ☑

SERVICE SIZE 1/2" LOC 1.8 m DIR S FROM N.E. COR. OF FENCE METHOD OF TIE P.E. MAT ST ☐ PL. ☐ PE. ☑ TAP SIZE

CURB COCK NO ☑ YES ☐ LOC. DRSR NO ☑ YES ☐ LOC. MA. SIZE BEL/GR. ENTRY ☐ INSIDE METER ☐

SERVICE PIPE

	LENGTH	SIZE
MN/PL.	9.0	1/2"
PL/BLDG.	14.2	
JOG		
VERT.		
EXT. PAST COR.	1.0	
RISER	1.0	
TOTAL RUN	25.2	1/2"
SCRAP	METRIC	

INSULATED AT MAIN ☐ PL. ☐
TEST & TRANS. ☐
RENEWAL PART ☐ COMP ☐
PRERUN TAPPED ☐ NOT TAPPED ☐ U/AIR ☐
OLD SERVICE CUTOFF YES ☐ NO ☐
AT MAIN ☐ OTHER
OLD PIPE REMOVED ☐ MN. PL. U/S
PIPE ABAN. LGTH. SIZE
METERS REMOVED
READING

UGHL. MA. SIZE SLATER ☐
CASING POSTS
PAVEMENT: SAVED-SIDEWALK PAVEMENT
PAVE. CUT ☐ TRENCH RUN CUT BELL HOLE
NO. OF CUTS AVG. THICKNESS CALLED IN YES ☐ NO ☐
METER NO. INSTALLED E 69165
READING 9571

INSPECTION REPORT: I HEREBY CERTIFY THAT THE PIPING WAS INSTALLED IN ACCORDANCE WITH AUTHORITY STANDARD PRACTICES AND WAS EXAMINED UNDER AN AIR TEST OF 640 kPa FOR 10 MINS. AND THAT NO LEAKAGE WAS INDICATED.

FOREMAN [signature] DATE Feb. 22/85

2437

FURTHER WORK REQ'D: YES ☐ NO ☑ WORK COMPLETED BY CONTRACTOR ☐

PROV. HWY DEPTH CHECKED BY SPVR: m COVER

SUPERVISOR [signature]

SHOW INSTALLATION OF SERVICE IN DETAIL AND LOCATION AND LENGTH OF ANY JOGS ALTERATIONS AND CUTOFFS.

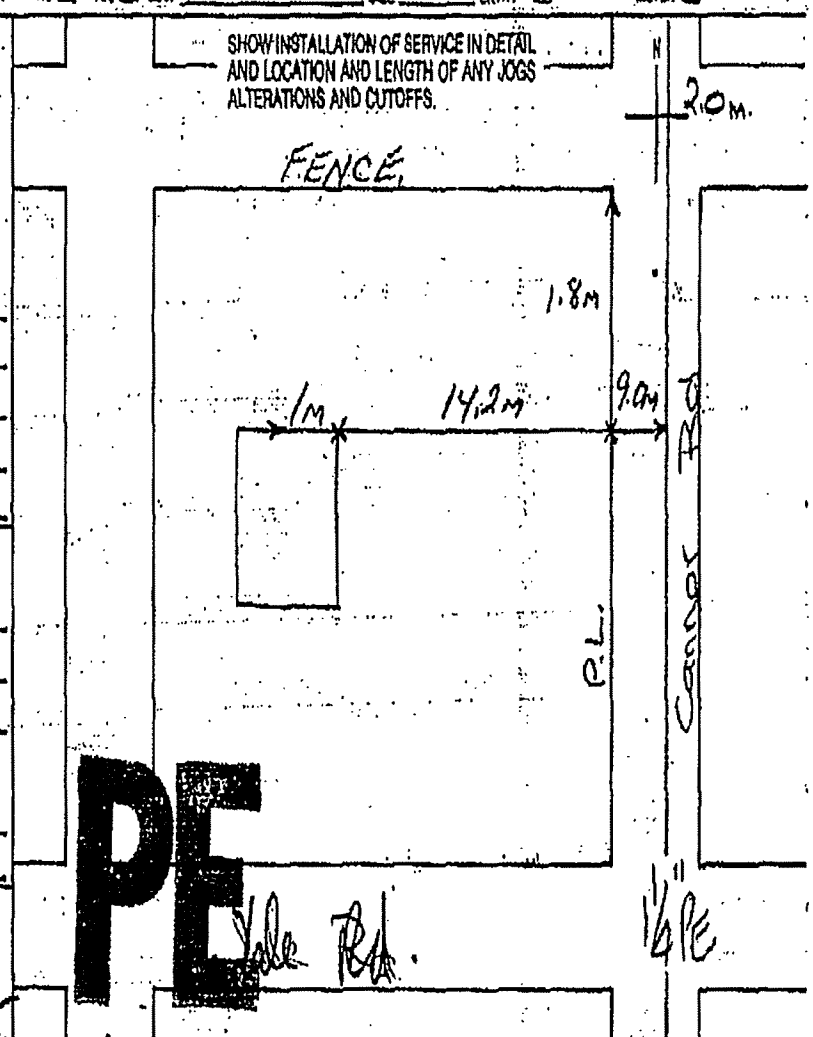

NOTICE TO CONTRACTORS: B.C. HYDRO & POWER AUTHORITY DOES NOT ACCEPT ANY RESPONSIBILITY FOR ERRORS OR OMISSIONS IN THE LOCATIONS SHOWN FOR EXISTING UNDERGROUND UTILITIES AND STRUCTURES. ALL SUCH LOCATIONS SHOWN ARE APPROXIMATE ONLY AND MUST BE CONFIRMED BY THE USE OF PIPE LOCATOR AND MANUAL DIGGING.

PREPARED FEEL. 1418 84-08-11 Dom-x B.1374